

512 S. Lynnhaven Road

Virginia Beach, VA 23452

S. Lynnhaven Road

LOCATION:

- Immediate Access to:
 - I-264
 - Virginia Beach Boulevard
- Located in the heart of the Lynnhaven business district
- In close proximity to numerous businesses, banks, restaurants and retailers

Property Information

OFFICE SPACE FOR LEASE:

- Professional office building
- Owner-occupied
- Monument signage available
- Approx. 1806 SF available
- \$13.50 PSF, net of utilities

OFFICE SPACE
FOR LEASE



For more information, please contact:

Rob Wright
rob@katsias.com
(757) 303-8936

John Katsias
john@katsias.com
(757) 285-8989



Brokerage with vision. Real estate with results.

2901 S. Lynnhaven
Suite 340
Virginia Beach, VA 23452

Phone 757.490.3585
Fax 757.490.3676
www.katsias.com


512 S. Lynnhaven Road

Virginia Beach, VA 23452

OFFICE SPACE
FOR LEASE


AS-BUILT FLOOR PLAN

SUITE 103
APPROX. 1,806 SF

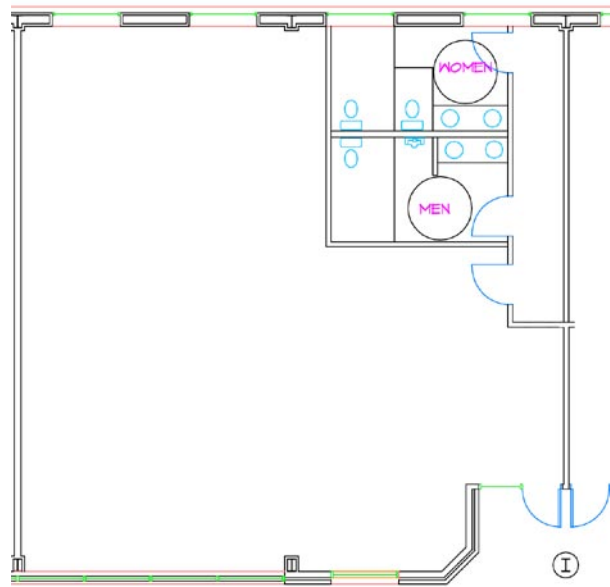

PROPOSED FLOOR PLAN

SUITE 103
APPROX. 1,806 SF

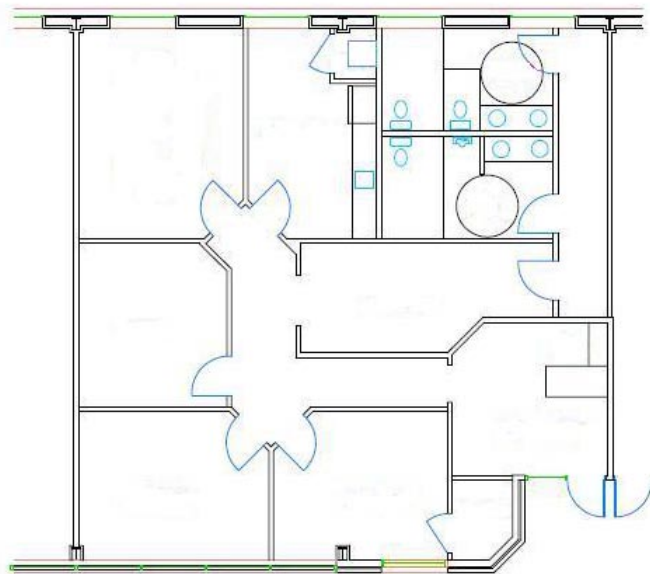

 The **KATSIAS**
COMPANY
Brokerage with vision. Real estate with results.

2901 S. Lynnhaven
Suite 340
Virginia Beach, VA 23452

Phone 757.490.3585
Fax 757.490.3676
www.katsias.com